




T/ AWNING  
EL. 15'-6"

B/ AWNING  
EL. 8'-3"

T/SIDEWALK  
EL. 0'-0"

1 FRONT ELEVATION  
SCALE: NTS

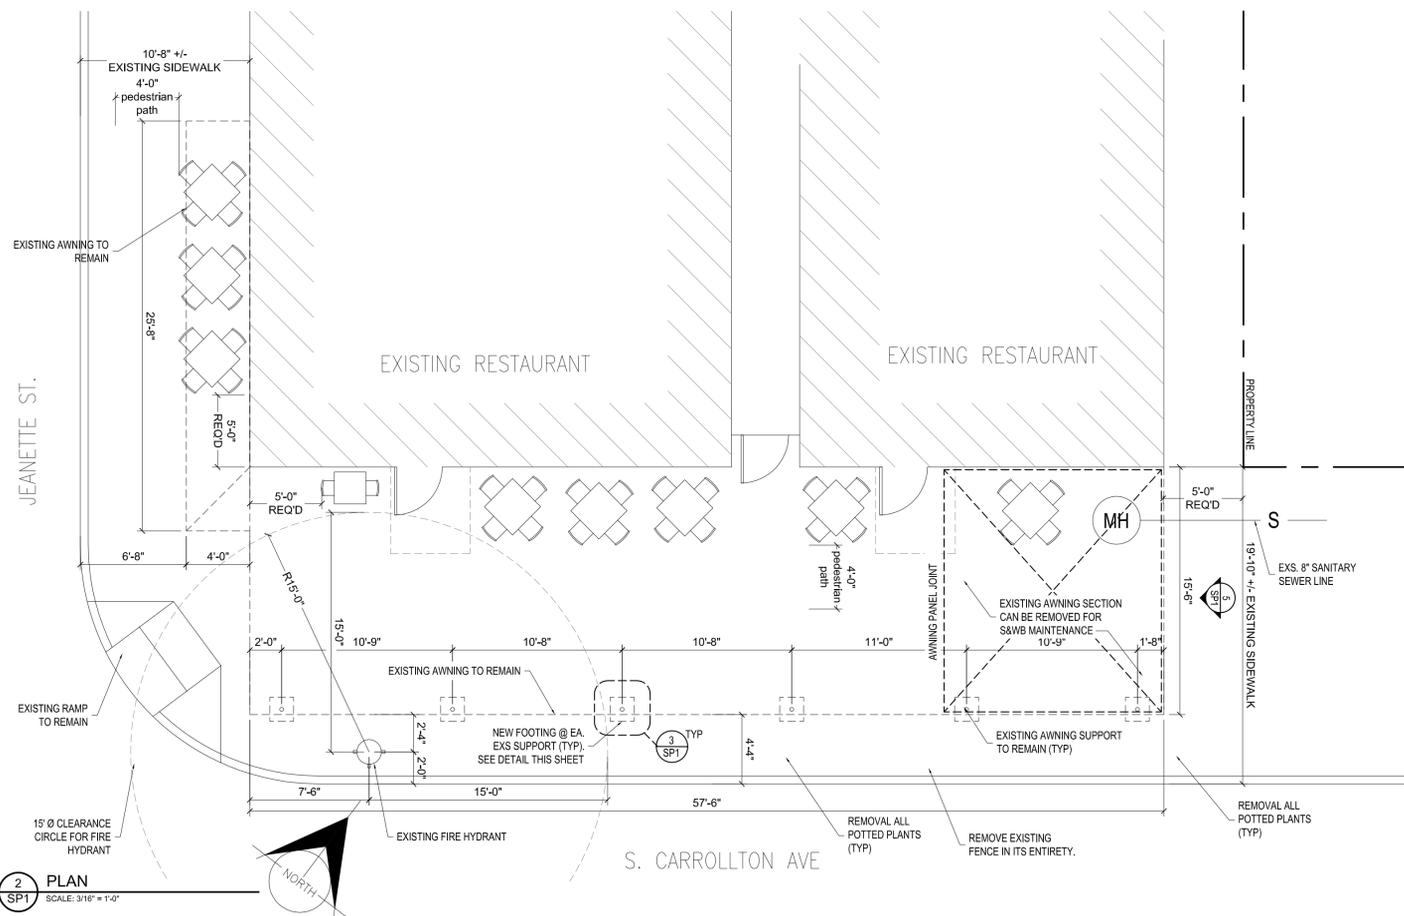

2 PLAN  
SCALE: 3/16" = 1'-0"




T/ AWNING  
EL. 15'-6"

B/ AWNING  
EL. 11'-2"

T/SIDEWALK  
EL. 0'-0"

B/ AWNING  
EL. 8'-3"


1A SIDE ELEVATION  
SCALE: NTS

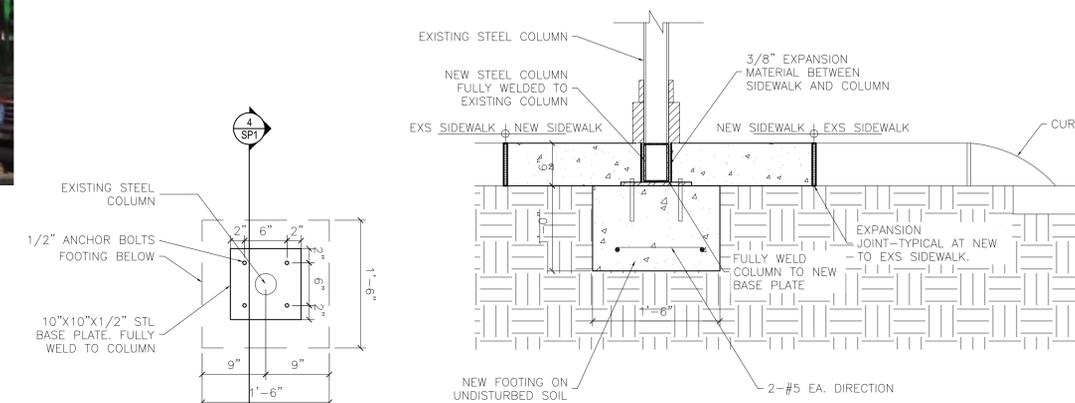

3 PLAN DETAIL  
SCALE: 1" = 1'-0"

4 SECTION  
SCALE: 1" = 1'-0"

**NOTE:**  
PRIOR TO WORK BEING DONE, COORDINATE WITH DEPARTMENT OF PUBLIC WORKS, NEW ORLEANS PARISH SEWAGE AND WATER BOARD, AND ENTERGY FOR EXISTING UTILITY LINE LOCATIONS

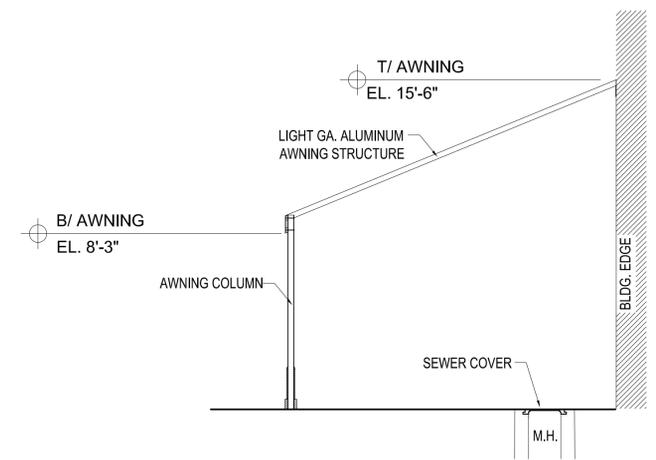


5 SECTION @ SIDE ELEVATION  
SCALE: 3/16" = 1'-0"

**AS-BUILT VERIFICATION**

TO THE BEST OF MY KNOWLEDGE THESE PLANS ARE DRAWN TO COMPLY WITH THE OWNER'S AND THE CITY OF NEW ORLEANS ONE STOP PERMITS AND LICENSE DEPT. THESE DRAWINGS ARE TO SHOW THE EXISTING CONDITIONS OF THE SITE AND MAINLY THE EXISTING ADDITION OF THE AWNING IN AN EFFORT TO PROVIDE TO ENHANCE THE DEVELOPMENT OF THE SIDEWALK. MOULTON LONG TURNER ARCHITECTS DID NOT PROVIDE THE DESIGN FOR THE AWNING ADDITION, ONLY THE DRAWING FOR THE EXISTING CONDITIONS. FIELD MEASUREMENTS AND DATA COLLECTION WAS DONE TO THE BEST OF OUR ABILITIES. MOULTON LONG TURNER ARCHITECTS DOES NOT WARRANT OR GUARANTEE THAT EXISTING AWNING WAS CONSTRUCTED TO MEET ALL APPLICABLE STATE AND PARISH CODES AND ORDINANCES.

Drawings and specifications as instruments of service are and shall remain the property of the architect whether the project for which they are made is executed or not. They are not to be used by the owner or anyone else on other projects or extensions to this project except by agreement in writing and with appropriate compensation to the Architect. Protected by U.S. copyright law.

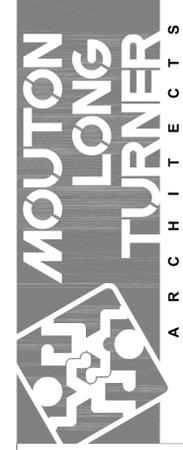

601 Poyworth Avenue  
Suite 200  
Metairie, LA 70005  
504.838.8091  
www.moultonlong.com

**EXISTING AWNING FOR  
1500 S. CARROLLTON AVE  
NEW ORLEANS, LA**

Issue		
Date	To	Remarks
10/10/14	-	PERMIT OFFICE
Revisions		
FOR 11-19-14 P.A.C.		

10/10/14  
Date: -  
Project No.  
Drawing No.  
**SP1**